
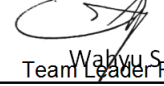



Title : LOT MANUFACTURE LABEL BED	1. Chair	① Material / Part	Prepared by	Checked by	Approved by
	② Nursing Bed 3. Lainnya ...	2. Metoda 3. Mesin 4. Lainnya ...	 Rini R&D Staff	 Wahyu S Team Leader R&D	 Ivo A Group Leader R&D

Subject : **PENAMBAHAN LOGO QC PASSED PADA DESAIN LOT MANUFACTURE LABEL PRODUK BED**


Isi

Reason


- Adanya temuan dari team audit CPAKB mengenai pemasangan QC Passed label

Solution


Berdasarkan alasan tersebut maka adanya penambahan design pada lot manufacture label dan label lot number accessories dengan penambahan logo QC Passed label, untuk kode SAP tidak ada perubahan masih menggunakan kode yang lama

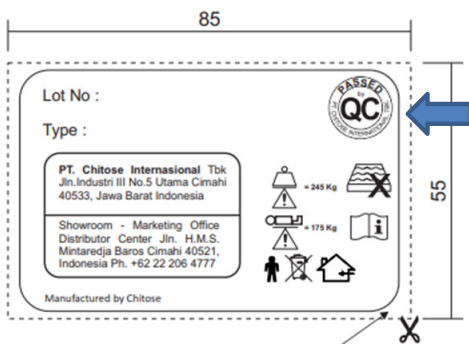

LOT MANUFACTURE LABEL FOR CRANK
(PT-ALL-OTH-PR-0017)

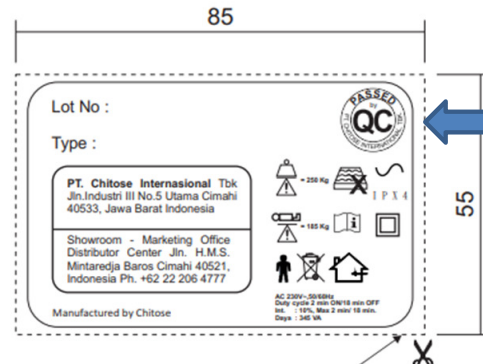

LOT MANUFACTURE LABEL FOR ELECTRIC
(PT-ALL-OTH-PR-0018)

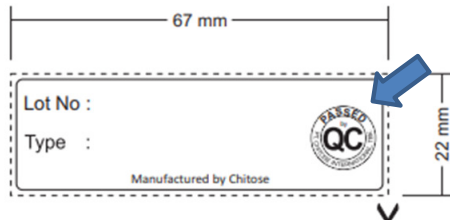

LABEL LOT NUMBER ACCESSORIES BED (WHITE)
(PT-000-PRD-PR-0048)

Catatan : - Teknikal Informasi ini berlaku sejak diterbitkannya TI ini


Lampiran : - GTKP terbaru

Demikian informasi ini disampaikan,
Atas perhatian dan kerjasamanya kami ucapkan terima kasih

Distribusi ke :

- | | | | |
|---------------------------|----------------------------|--------------|----------------|
| 1 President Director | 6 Engineerin.* Maintenance | 10 MIS | ⑮ PCH |
| 2 Administration Director | * Workshop | 11 Marketing | ⑯ QC |
| 3 PRD Director | 7 Finance | 12 Sales | ⑰ MSD |
| 4 Marketing Director | 8 General Affair | ⑬ Production | ⑱ Others ...() |
| 5 Cost Accounting | 9 HRD | ⑭ PPIC | |


No.	Kode	Nama Komponen	Qty	Spesifikasi Komponen
1.	-	Manufacture label Crank Manual Type	1	HVS Sticker 85 x 55

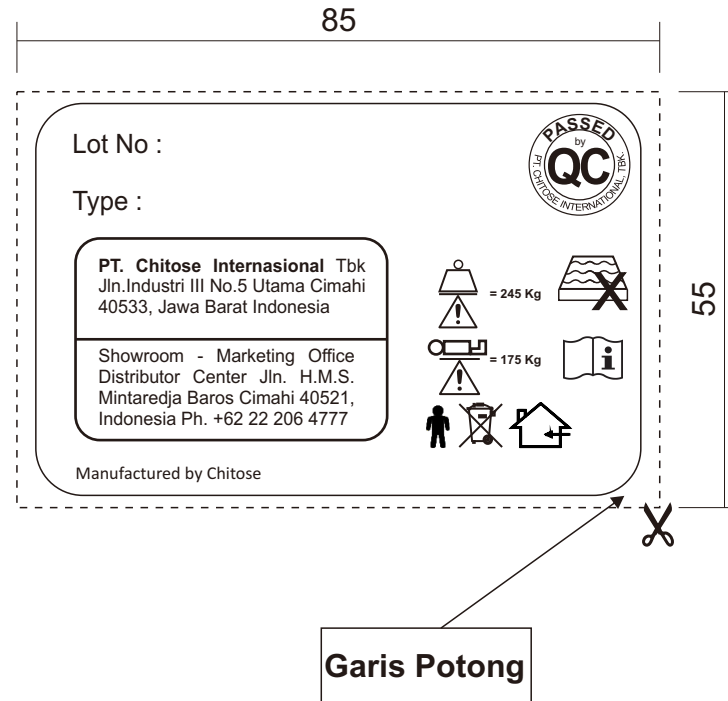

- Note :
1. label akan di aplikasikan dengan tinta cap
 2. Tinta cap tidak mudah luntur

3								Standard Application :	Specification :	Finishing :	Unit :	Papper :	Scale :	Projection :	Drawing Name :
2											mm	A4	1:1		Manufacture label Crank Manual type
1								Drawn :	Designed/ Customer :	Checked :	Approved :	Status :	Effective Date :	Page :	Product Name :
NO	DATE	REMARK	DRAWN	CHECKED	APPROVED	APPROVED	Wahyu	CINT	M.Rosyidin	Donald KL	PRODUCTION DRAWING	-	PT. Chitose Internasional Tbk Research and Development Dept.		NSB

No.	Kode	Nama Komponen	Qty	Spesifikasi Komponen
1.	-	Manufacture Label for Accesories	1	HVS Sticker 67 x 22

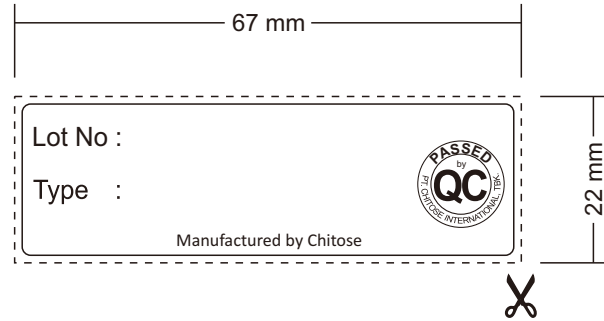

3							Standard Application :		Specification :	Finishing :	Unit :	Papper :	Scale :	Projection :	Drawing Name :
2											mm	A4	1:1		Manufacture Label for Accesories
1							Drawn :	Designed/ Customer :	Checked :	Approved :	Status :	Effective Date :	Page :		Product Name :
NO	DATE	REMARK	DRAWN	CHECKED	APPROVED	APPROVED	Wahyu	CINT	M.Rosyidin	Donald KL	PRODUCTION DRAWING		-	PT. Chitose Internasional Tbk Research and Development Dept.	NSB